




2 Front Elevation
A200
1/4" = 1'-0"



4 Right Elevation
A200
1/4" = 1'-0"

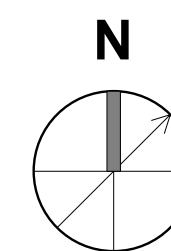

Not For Construction

WARNING:
Joe The Architect, Inc. all drawings and written material herein constitute the original and copyrighted work of the architect, and the same may not be duplicated, used, or disclosed without the written consent of the architect. Contractors to use Architectural Drawings for set out. Contractors to check and verify all Dimensions on site prior to Construction/Fabrication. Figure Dimensions take precedence over Scaled Dimensions. Any discrepancies should be immediately referred to the Architect. The project manager shall be notified in writing of any discrepancies prior to proceeding with the work. The scale of drawings may change when copied or traced. All work to comply with I.B.C. Regulations and relevant American Standards.
© 2019 - all rights reserved.

consultant / contractor information:

stamp:

revision	revision description	date

project title:
21 Cherry Street

21 Cherry Street
Somerville MA

client information:
LaCourt Realty

J t A

JOE THE ARCHITECT

343 Medford Street, Suite 410, Somerville, MA 02145
t + (617) 764-3553 e: askjoe@joethearchitect.com
www.joethearchitect.com


drawing title:
Existing Elevations

project number	drawing scale	approver
000	1/4" = 1'-0"	Approver
drawing number	revision	
A200		

NOT FOR CONSTRUCTION 10/27/2020 2:18:00 PM



1 Rear Elevation
A210 1/4" = 1'-0"

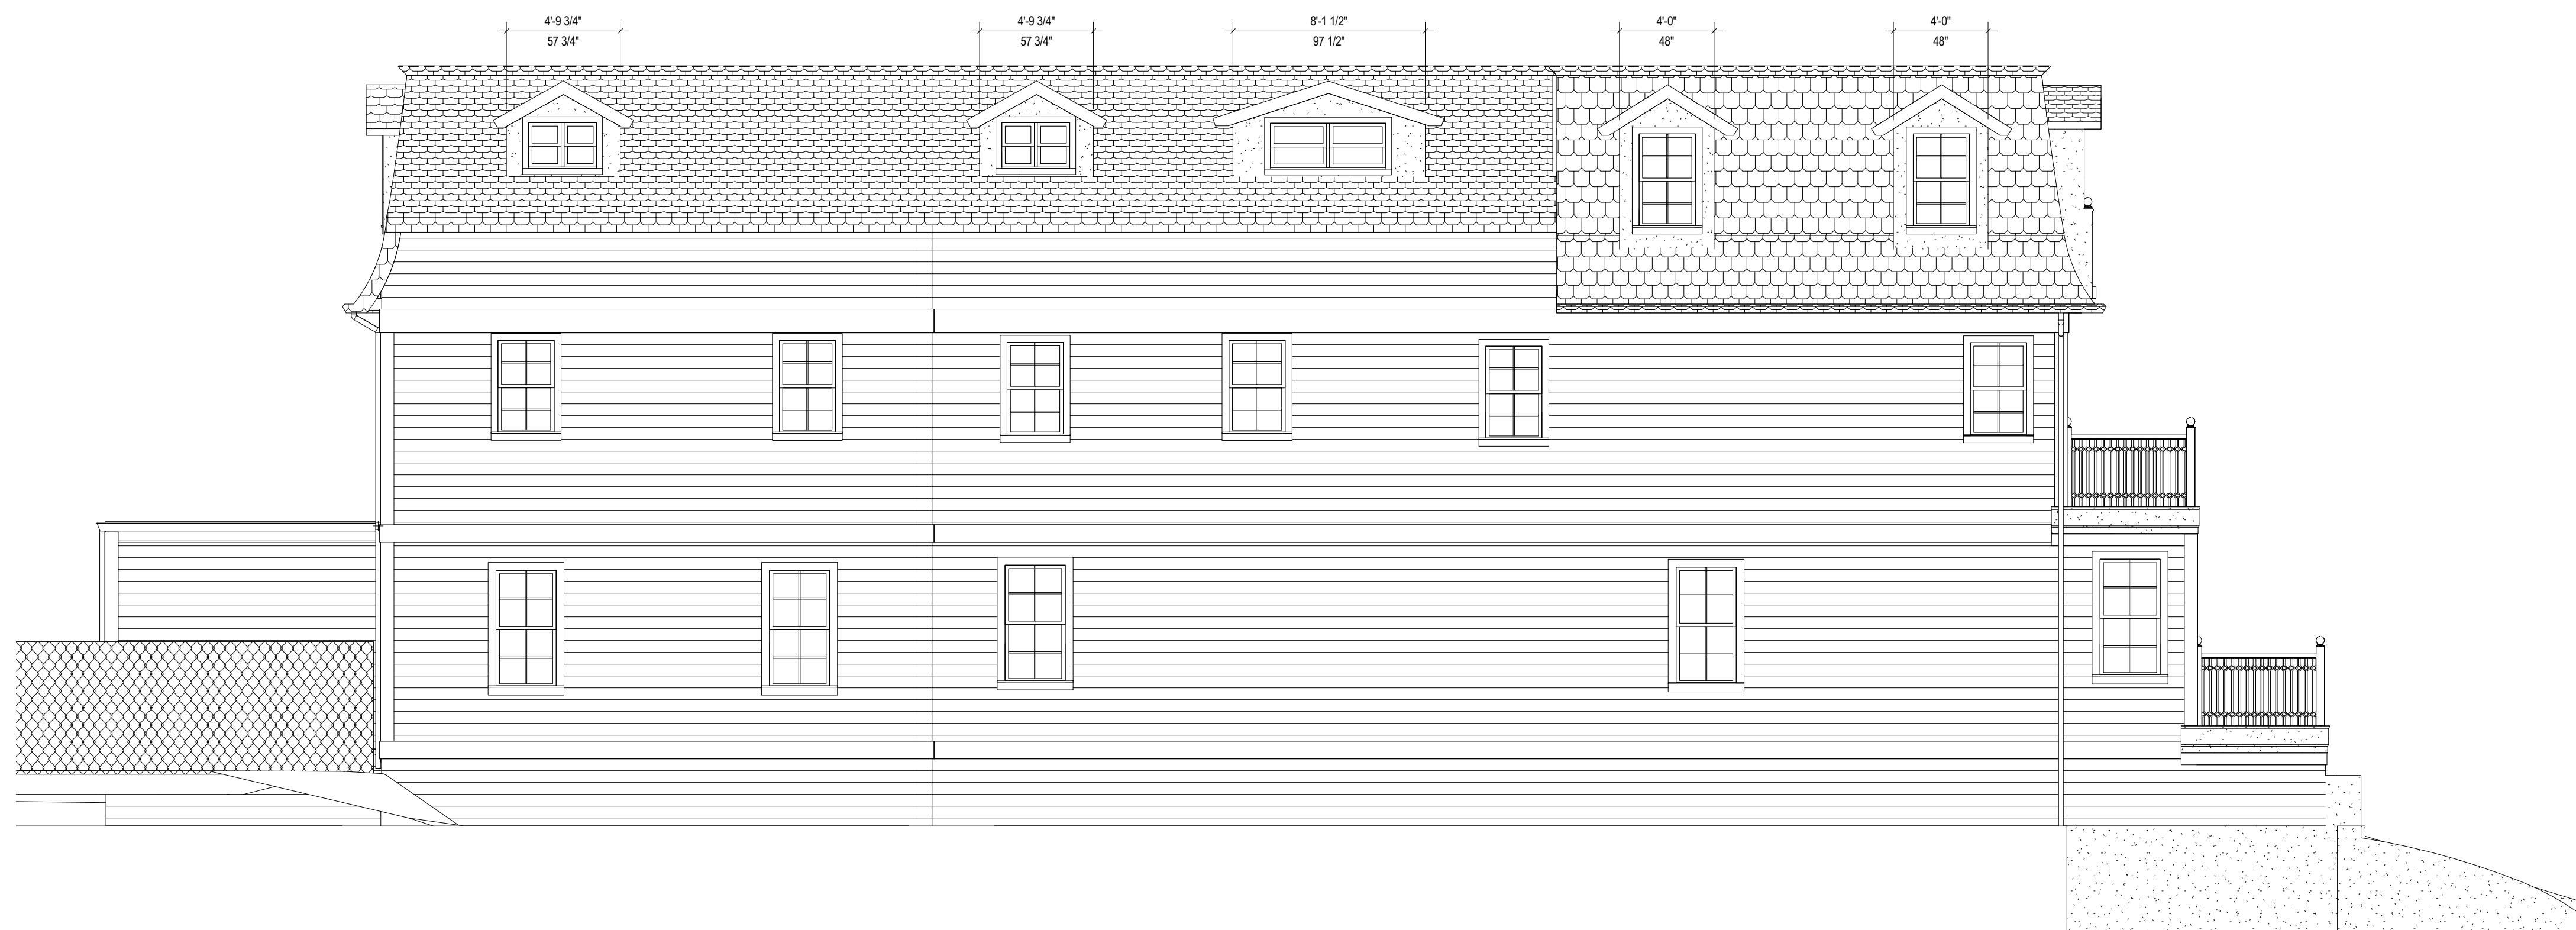

2 Left Elevation
A210 1/4" = 1'-0"

Not For Construction

WARNING:
Joe The Architect, Inc. all drawings and written material herein constitute the original and copyrighted work of the architect, and the same may not be duplicated, used, or disclosed without the written consent of the architect. Contractors to use Architectural drawings for set out. Contractors to check and verify all Dimensions on site prior to Construction/Fabrication. Figure Dimensions take precedence over Scaled Dimensions. Any discrepancies should be immediately referred to the Architect. The project manager shall be notified in writing of any discrepancies prior to proceeding with the work. The scale of drawings may change when copied or used. All work to comply with I.B.C. Regulations and relevant American Standards.
© 2019 - all rights reserved.

consultant / contractor information:

stamp:

revision	revision description	date

project title:
21 Cherry Street

21 Cherry Street
Somerville MA

client information:
LaCourt Realty


J t A

JOE THE ARCHITECT

343 Medford Street, Suite 410, Somerville, MA 02145
t + (617) 764-3553 e askjoe@joethearchitect.com
www.joethearchitect.com

drawing title
Existing Elevations

project number	drawing scale	approver
000	1/4" = 1'-0"	Approver
drawing number	revision	
A210		

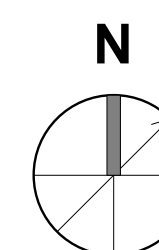

NOT FOR CONSTRUCTION 10/27/2020 2:18:04 PM