
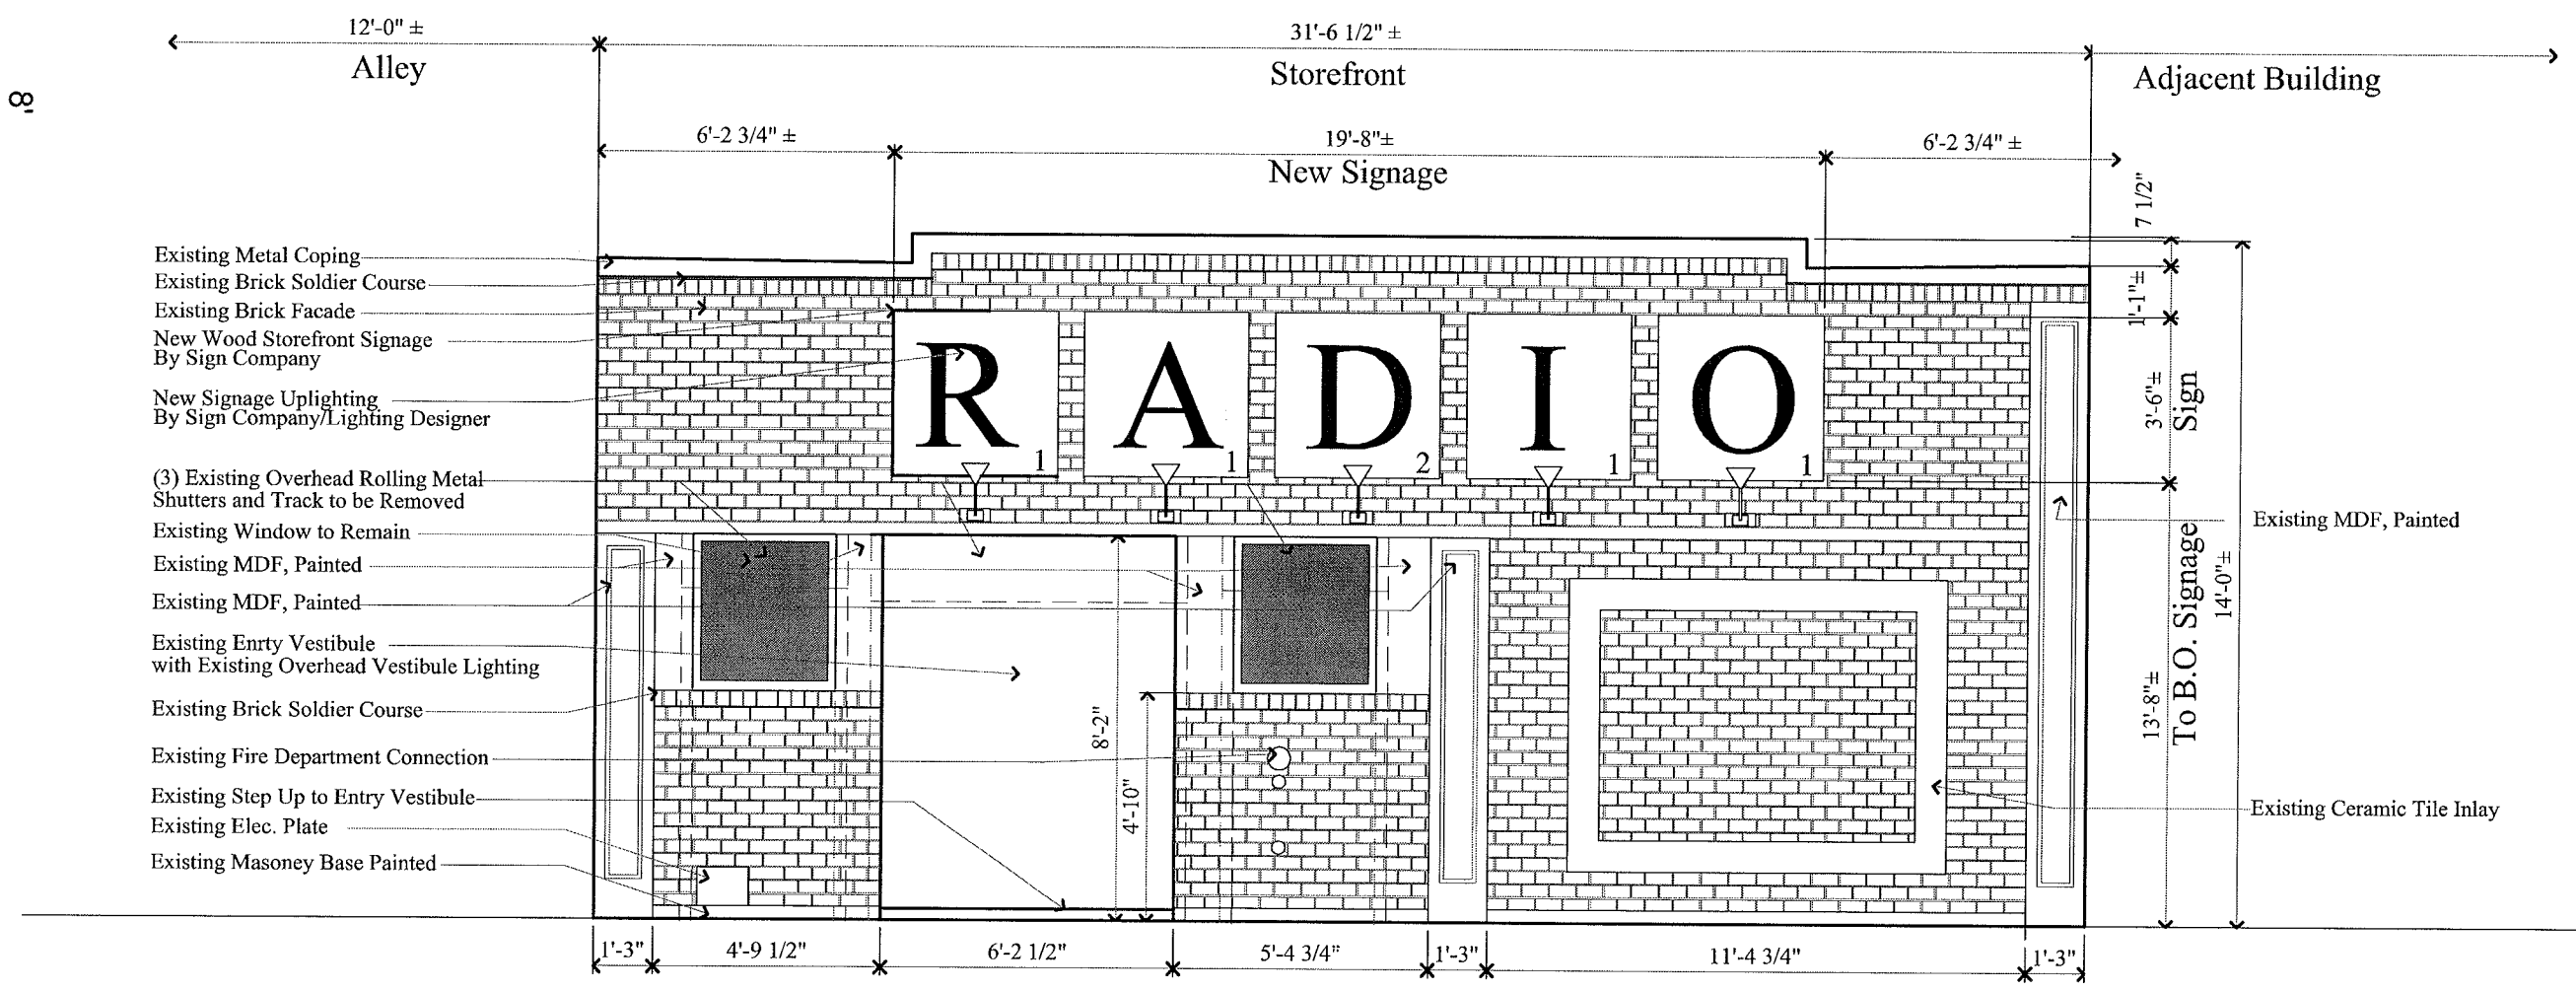


Project:
RADIO
 379 SOMERVILLE AVE.
 SOMERVILLE, MA

PROPOSED STOREFRONT ELEVATION

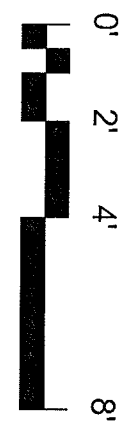

PROPOSED STOREFRONT ELEVATION
 SCALE: 1/4"=1'-0"

Note: Existing "CHOICES" Awning to be Removed and Will be Replaced with New Storefront Signage as Shown Above. Signage by Sign Company

blanchardA+D, LLC
 49 Cherry Street
 Somerville, MA 02144

Scale: 1/4"=1'-0"
 Date: October 28, 2011

Sheet No.
A2.0


Project:
RADIO
379 SOMERVILLE AVE.
SOMERVILLE, MA

Issue Dates and Revisions:

Not For Construction

General Notes:
 General Contractor shall make all Subcontractors and Suppliers aware of the requirements of these notes.
 All work shall be performed in compliance with all applicable Local, State and National Building, Life Safety and Electrical Codes.
 General Contractor shall be responsible for securing all permits as necessary for the completion of work shown throughout the Contract Documents.
 General Contractor shall lay out in the field the entire work to verify dimensional relationships before constructing any part, and shall verify all existing conditions and locations before proceeding.
 Failure to verify dimensions and conditions before proceeding may subject the General Contractor to the required removal of completed work at General Contractor cost, if a discrepancy which could have been discovered causes modifications to the plans.
 General Contractor shall coordinate the dimensional requirements between the work of the various trades.
 Any discrepancies found in the plans, dimensions, existing conditions or any apparent error in the classifying or specifying of a product, material or means of assembly is to be pointed out to the Architect immediately.
 Drawings shall not be scaled for dimensions and/or sizes. Owner and Architect assume no responsibility for use of incorrect scale.
 Regardless of whether or not an item is shown or specified, General Contractor shall provide said item if it is necessary for the proper installation or function of an item shown or specified. Suppliers and Subcontractors shall inform the General Contractor of their requirements for the work of other trades, which may not be indicated, prior to bidding.
 All dimensions to interior/exterior walls indicated are to face of stud wall or concrete, m. u. unless noted otherwise.

Copyright Note:
 Blanchard A+D (Architect) expressly reserves the Common Law Copyrights and other Property Rights in these Drawings. These drawings are the property of blanchard A+D and shall not be reproduced in any manner nor shall they be assigned for use to any third party without first obtaining the expressed written permission from blanchard A+D (Architect).
 © 2011 blanchard A+D, LLC

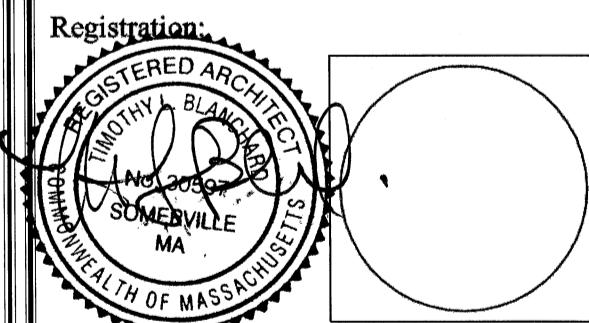

Registration:
 Drawing Title:
"As-Built" Plan
Main Level/Basement

Drawn: thianchard@gmail.com

Checked: thianchard@gmail.com

Project Number:

Date: October 28, 2011

Drawing Number:

A1.0

MEP LEGEND

⊕	OUTLET	⊙	CABLE
⊕	FOURPLEX	⊕	PENDANT FIXTURE
⊕	GROUND FAULT	⊕	RECESSED FIXTURE
⊕	EXTERIOR OUTLET	⊕	EMERGENCY LIGHTING
⊕	FLOOR OUTLET	⊕	WALL-MOUNT FIXTURE
⊕	SWITCH	⊕	SURFACE FIXTURE
⊕	3-WAY SWITCH	⊕	SURFACE MOUNTED FLUORESCENT FIXTURE
⊕	HEAT DETECTOR	⊕	WALL-MOUNT FIXTURE EXTERIOR
⊕	TELEPHONE	⊕	PENDANT FIXTURE EXTERIOR
EXIT	EXIT SIGN w/ EMERG. LIGHT	⊕	SURFACE MOUNTED FIXTURE EXTERIOR
SP	STAND PIPE	⊕	TOILET RM. EXHAUST/SURFACE MOUNT LIGHT
⊕	FIRE ALARM PULL STATION	⊕	TRACK LIGHTING
⊕	FIRE EXTINGUISHER	⊕	FAN w/ LIGHT
CHEM	WET CHEMICAL FIRE SUPPRESSION SYSTEM	⊕	EXIT
E. L.T.S.	WET CHEMICAL FIRE SUPPRESSION SYSTEM	HVAC	HVAC CONTROLS
⊕	FIRE STROBE	●	FLOOR DRAIN
— SPR	FIRE SPRINKLER	⊕	HVAC GRILL IN CEILING

