SUBMITTED 11/21/17

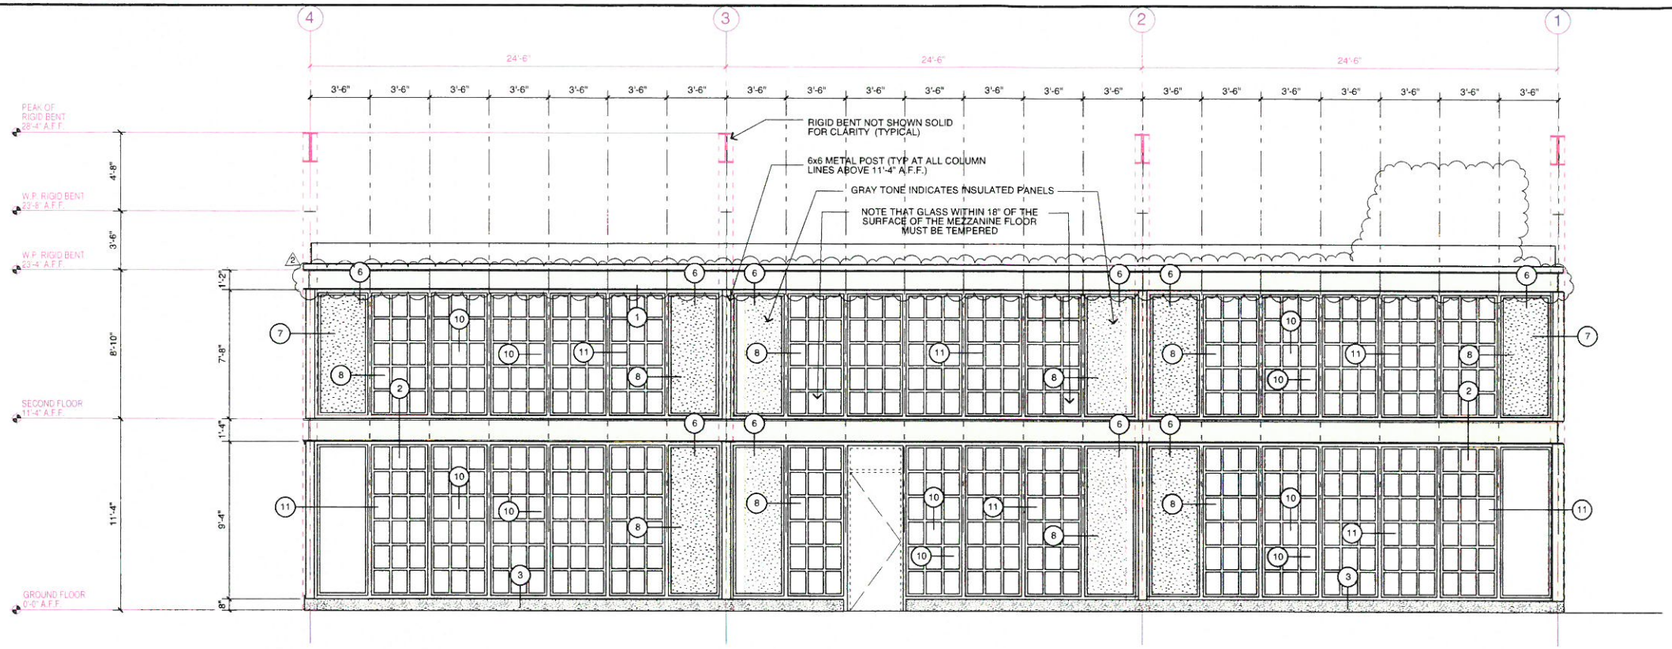

1 WEST ELEVATION

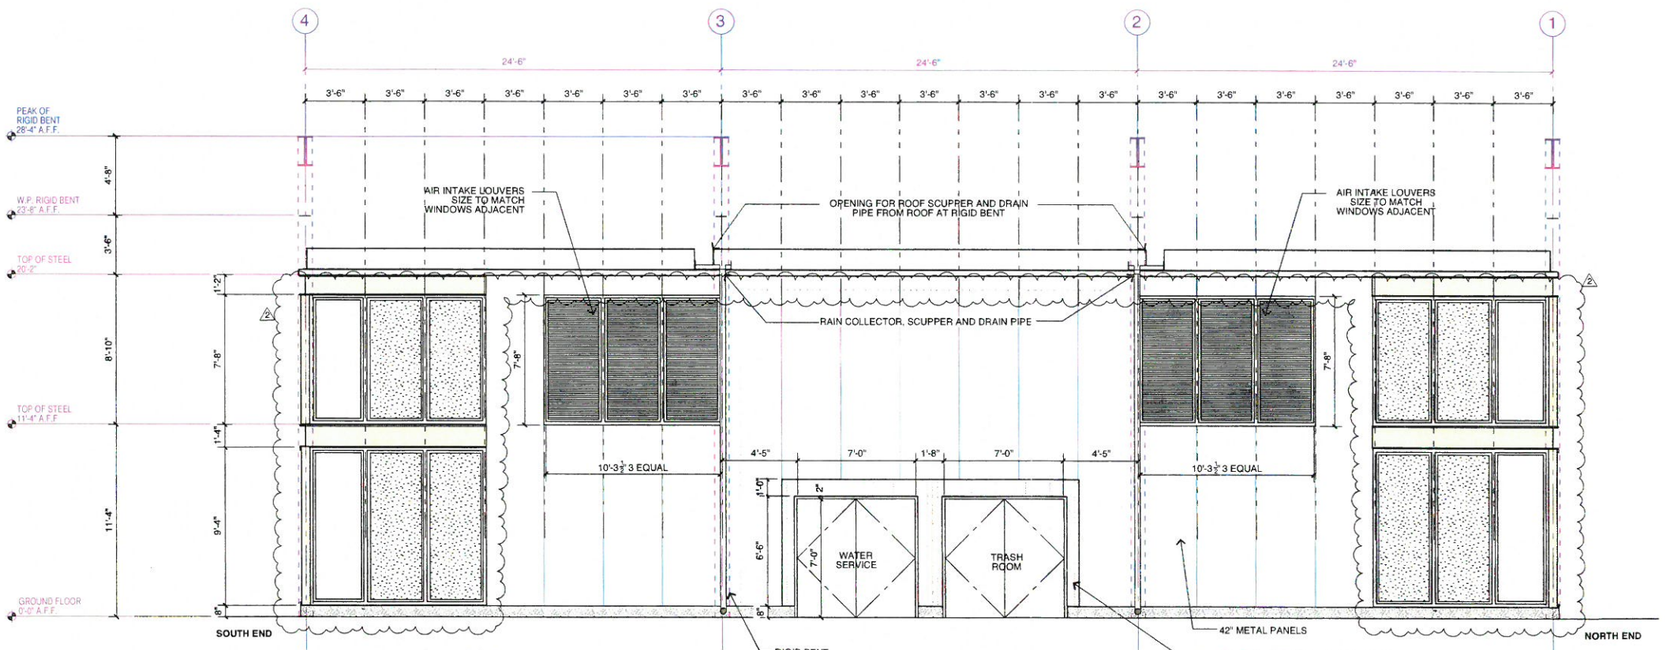

2 EAST ELEVATION

0 1' 2' 4' 8'

D'AGOSTINO IZZO QUIRK ARCHITECTS

Federal Realty INVESTMENT TRUST

owner:
FEDERAL REALTY INVESTMENT TRUST
ASSEMBLY ROW
450 ARTISAN WAY, SUITE 320
SOMERVILLE MA 02145
PHONE: (617) 684-1508

Project Architect:
D'AGOSTINO IZZO QUIRK ARCHITECTS, Inc.
1310 BROADWAY
SOMERVILLE, MA 02144
PHONE: (617) 623-3000

Structural Engineer:
McNAMARA SALVIA, Inc.
160 FEDERAL STREET
BOSTON MA 02110
PHONE: (617) 737-0040

Mechanical Engineer:
WSP FLACK & KURTZ
88 BLACK FALCON AVENUE, SUITE 210
BOSTON MA 02110
PHONE: (617) 210-1600

Specifications
WIL-SPEC
15 POST OFFICE SQUARE
LYNNFIELD MA 01940
PHONE: (781) 598-6789

STAMP

REVISIONS

DATE	ISSUED FOR
30 JUNE 2016	BID SET
05 AUG 2016	PERMIT SET
22 NOV 2016	BULLETIN 1
23 JAN 2017	BULLETIN 2

LINEAR PARK BUILDINGS: BUILDING B

DRAWING TITLE
WEST AND EAST ELEVATIONS
AS-BUILT CONDITION

SCALE	DRAWN BY	DATE	JOB NUMBER
1/2" = 1'-0"	CMD	22 NOV 2016	15008

BA3.2

SUBMITTED 11/21/17

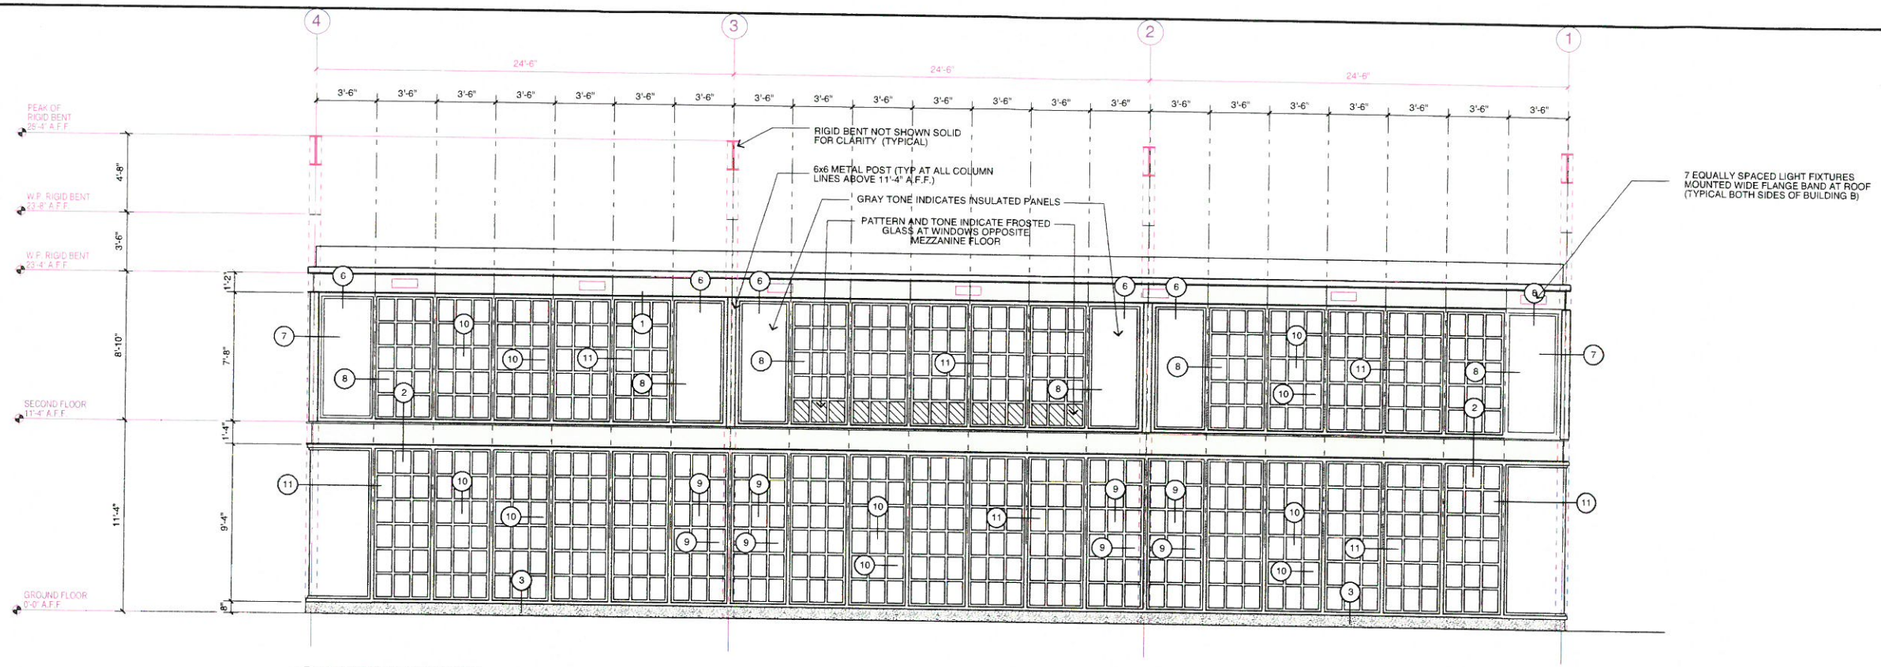

1 WEST ELEVATION

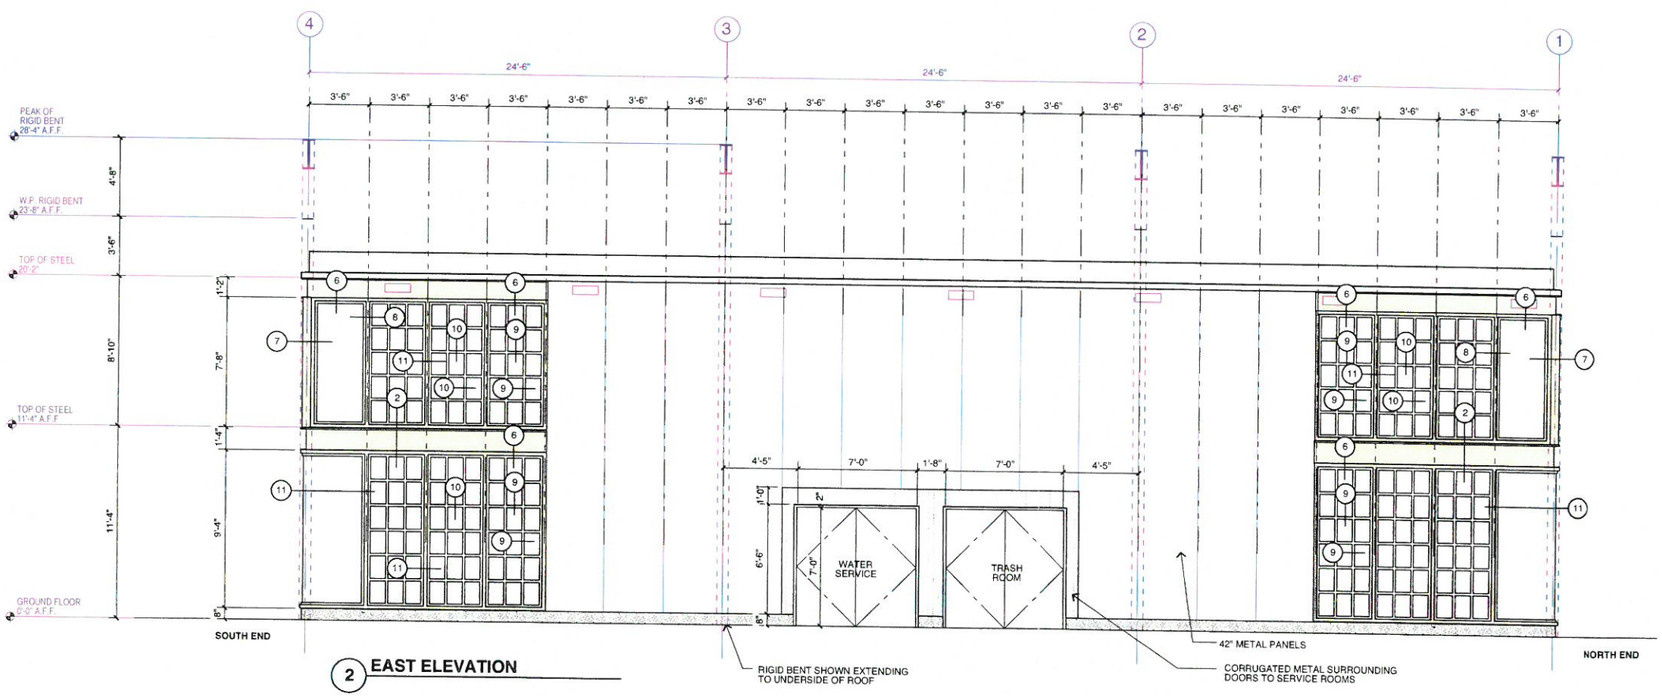

2 EAST ELEVATION

0 1' 2' 4' 8'

D'AGOSTINO IZZO QUIRK ARCHITECTS

Federal Realty INVESTMENT TRUST

owner:
FEDERAL REALTY INVESTMENT TRUST
ASSEMBLY ROW
5 MIDDLESEX AVENUE, 4TH FLOOR
SOMERVILLE MA 02145
PHONE: (617) 684-1508

Project Architect:
D'AGOSTINO IZZO QUIRK ARCHITECTS, Inc.
1310 BROADWAY
SOMERVILLE, MA 02144
PHONE: (617) 623-3000

Structural Engineer:
McNAMARA SALVIA, Inc.
160 FEDERAL STREET
BOSTON MA 02110
PHONE: (617) 737-0040

Mechanical Engineer:
WSP FLACK & KURTZ
88 BLACK FALCON AVENUE, SUITE 210
BOSTON MA 02110
PHONE: (617) 210-1600

Specifications
WIL-SPEC
15 POST OFFICE SQUARE
LYNNFIELD MA 01940
PHONE: (781) 598-6789

STAMP

REVISIONS

DATE	ISSUED FOR
30 JUNE 2016	BID SET
05 AUG 2016	PERMIT SET

LINEAR PARK BUILDINGS: BUILDING B

DRAWING TITLE
WEST AND EAST ELEVATIONS
APPROVED ELEVATION

BA3.2

SCALE	DRAWN BY	DATE	JOB NUMBER
1/2" = 1'-0"	CMD	05 AUG 2016	15008

15008 BA3.2-W-E Elevs.PDF

SUBMITTED 11/21/17

LINEAR PARK: BUILDING B
PROPOSED DECORATIVE
SCREENING AT LOUVERS